

AS-BUILT RECORD DRAWINGS FOR THE


LEACHATE POND CLOSURE

BRIDGETON LANDFILL

BRIDGETON, MISSOURI

APRIL 2005

PREPARED FOR:
BRIDGETON LANDFILL, LLC.

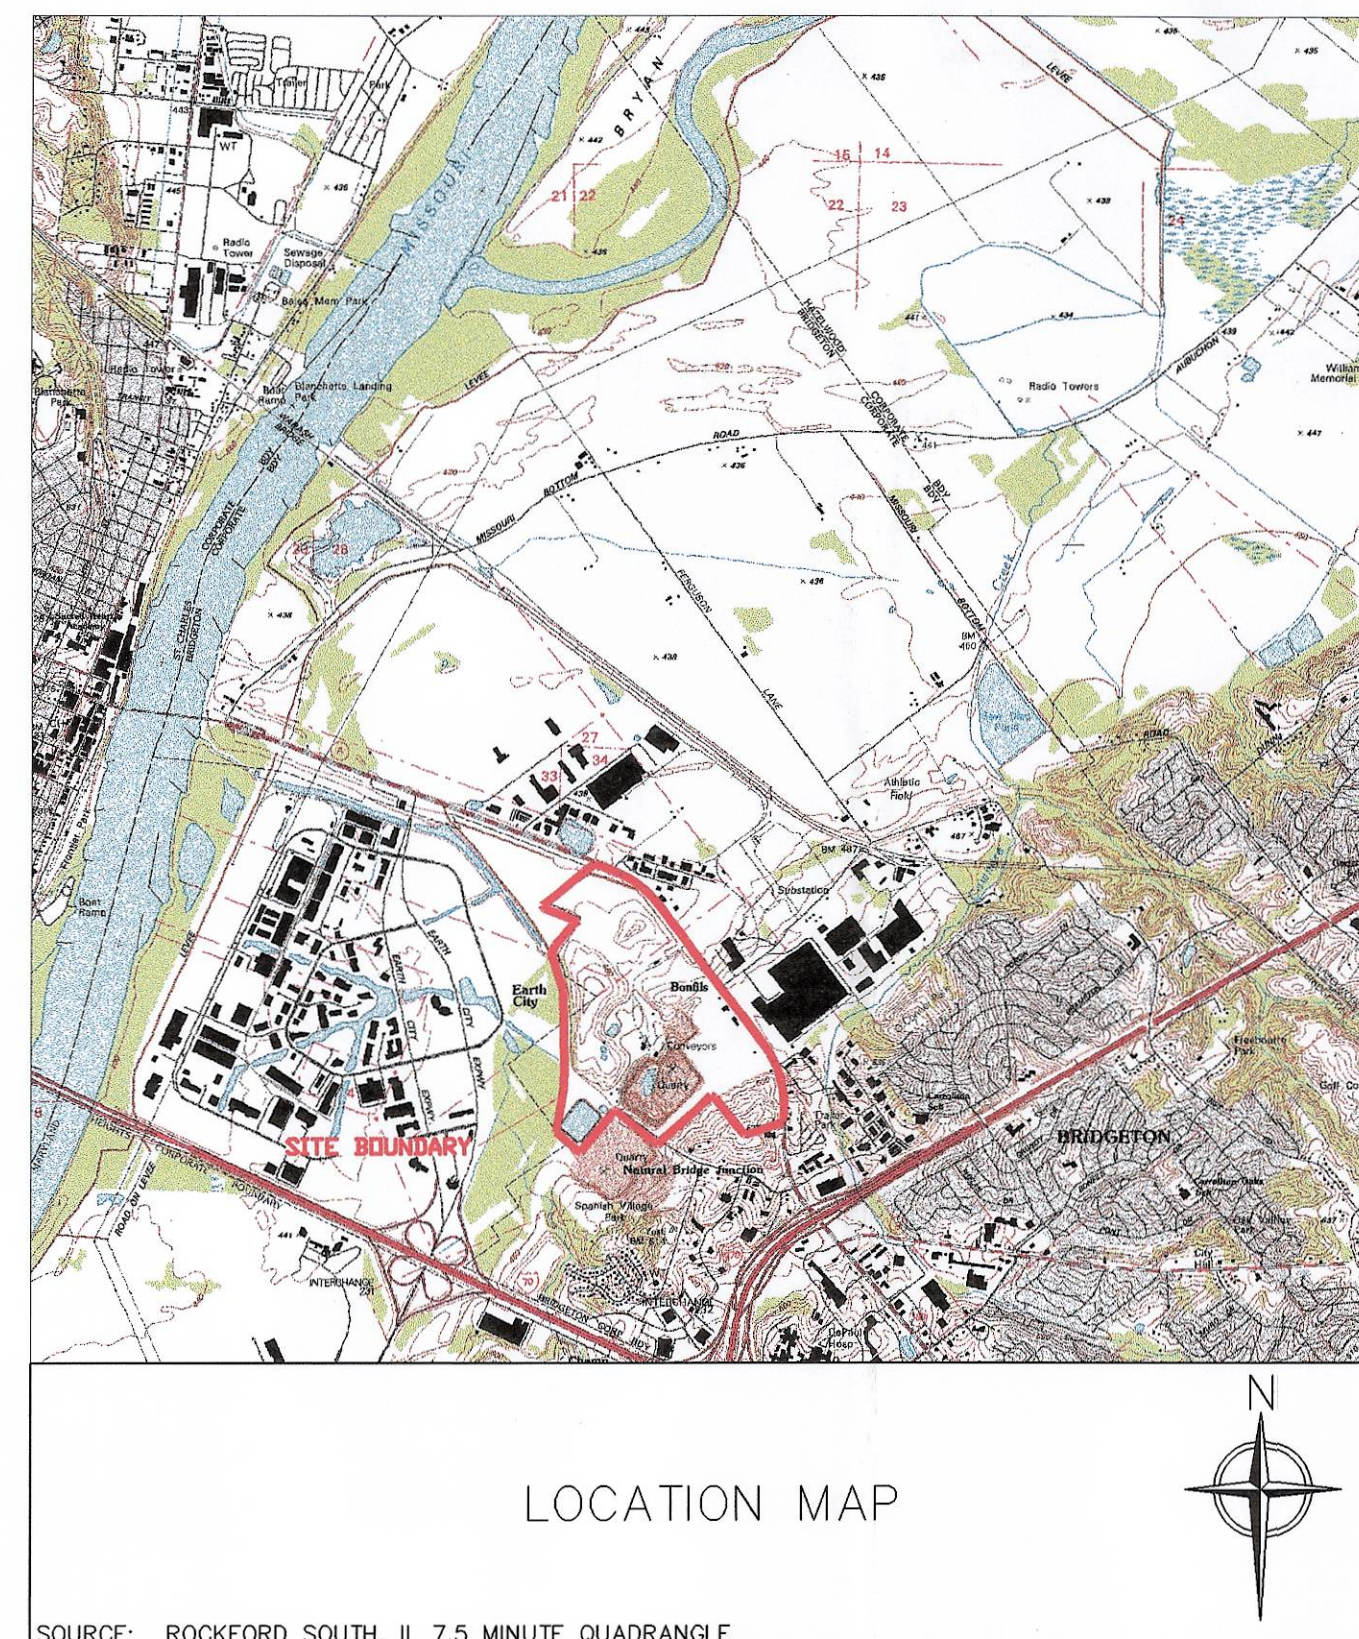


2445 SOUTH FIFTH STREET
SUITE 201
SPRINGFIELD, IL 62703
TEL. (217) 753-3988
FAX. (217) 753-3989



INDEX OF DRAWINGS

001	TITLE PAGE
002	EXISTING CONDITIONS
003	EXCAVATION GRADES
004	FINAL CONDITIONS

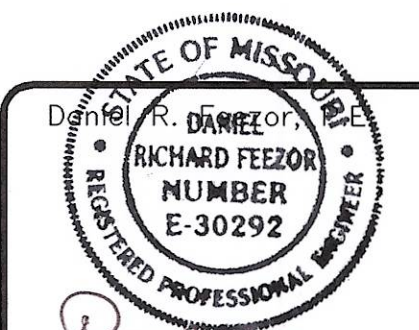


CHANGES TO THIS PLAN/DRAWING SET REQUIRE WRITTEN APPROVAL BY FEI.

MO P.E. No: 030292


Date



- LEGEND
- 320— INDEX CONTOUR
 - INTERMEDIATE CONTOUR
 - x- FENCELINE

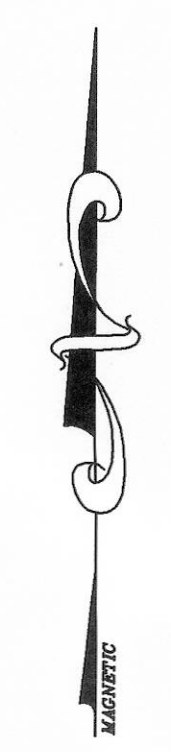

NOTE:
TOPOGRAPHY BASED UPON 3-1-2004 AERIAL SURVEY
BY SANBORN, INC.

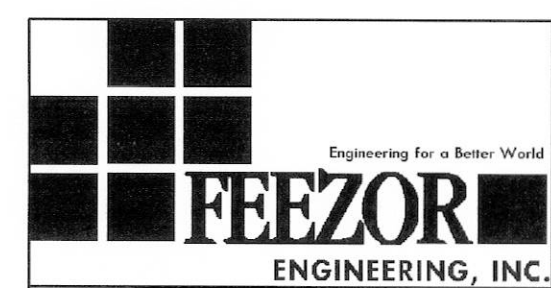


DESIGNED BY: NAC SCALE: 1"=300'
APPROVED BY: DRF DATE: 4-2005
PATH: C:\FEI\SITES\BT\BT001

PREPARED FOR:
BRIDGETON LANDFILL, L.L.C.
13570 ST. CHARLES ROCK ROAD
BRIDGETON, MD 63044

BRIDGETON LANDFILL
LEACHATE POND CLOSURE
AS-BUILT RECORD DRAWINGS

EXISTING CONDITIONS


PROJECT NO.: BT-001 DRAWING NO.: 002

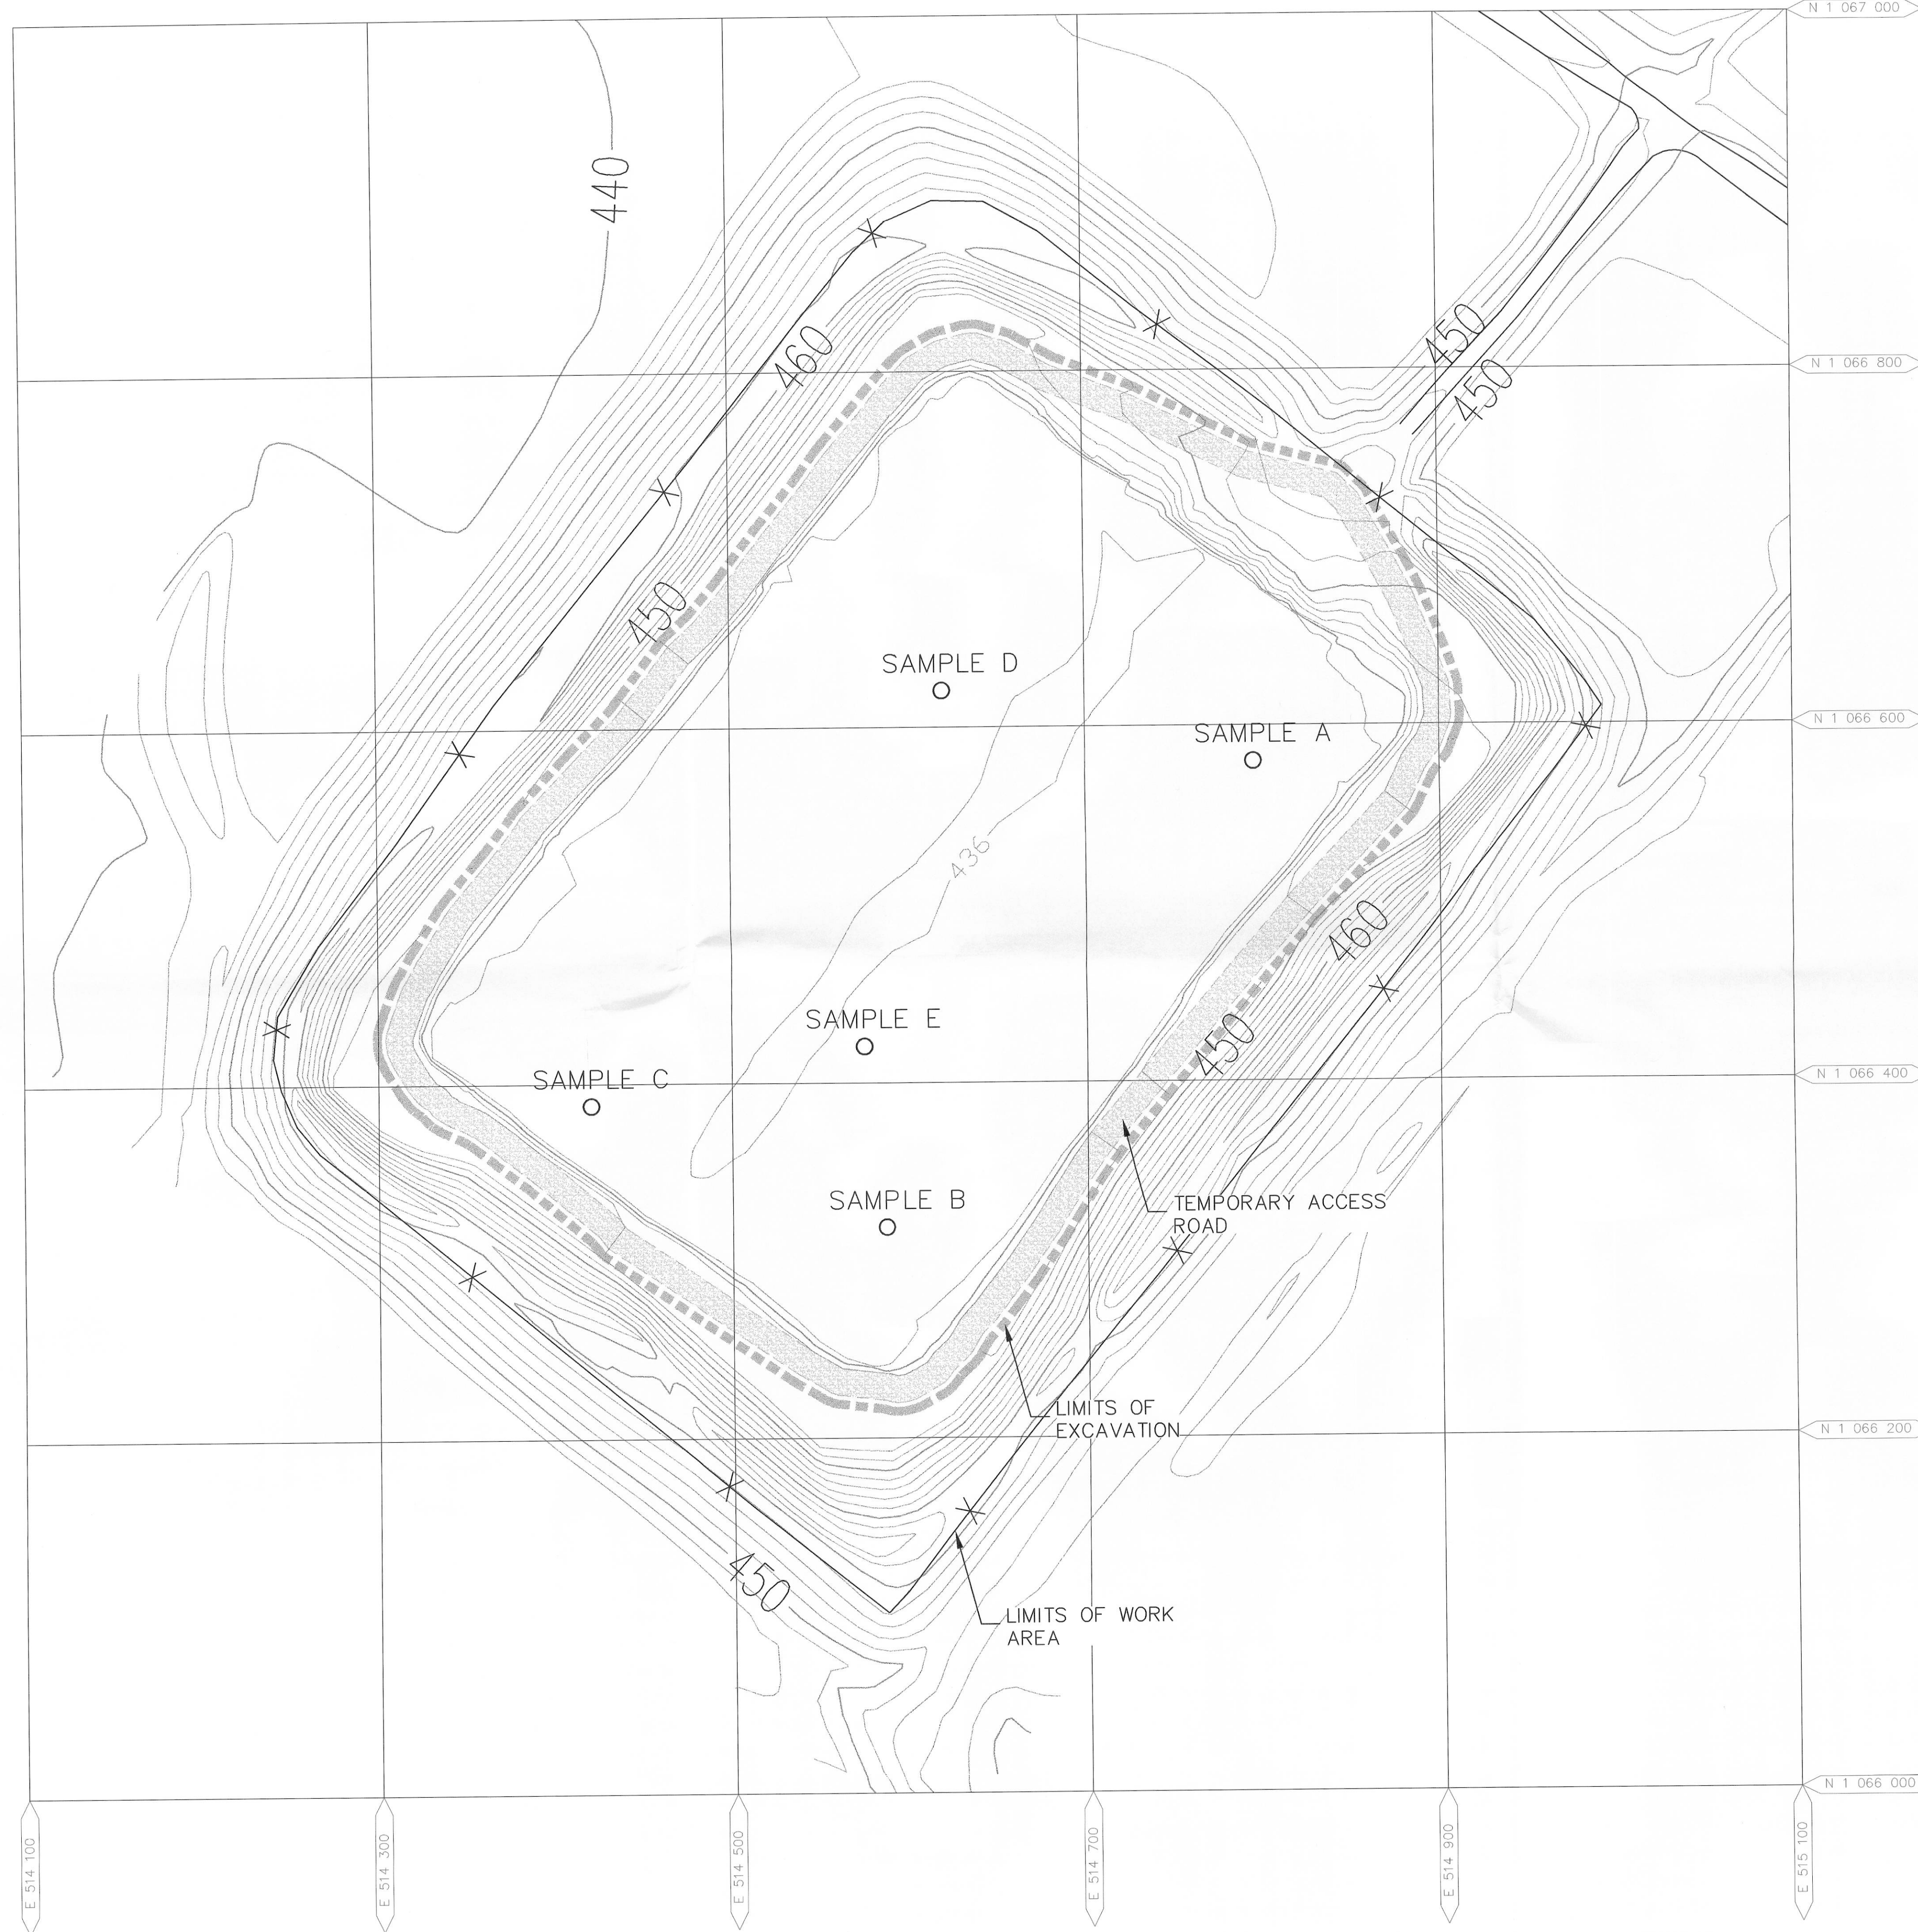


LEGEND
—320— INDEX CONTOUR
— — — INTERMEDIATE CONTOUR
— X — FENCELINE

NOTE:


- (1) TOPOGRAPHY BASED UPON 3-1-2004 AERIAL SURVEY BY SANBORN, INC.
- (2) EXCAVATION SURVEY DATA TAKEN FROM STANLEY HOLZHAUER, PLS SURVEY DATED 5-11-2004.

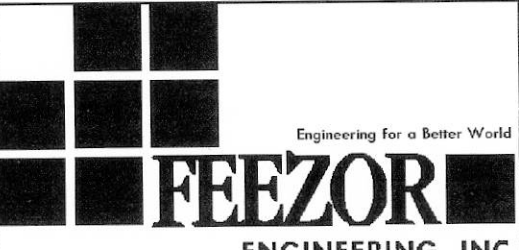 ENGINEERING, INC. Engineering for a Better World		PREPARED FOR: BRIDGETON LANDFILL L.L.C. 13570 ST. CHARLES ROCK ROAD BRIDGETON, MD 63044	
		BRIDGETON LANDFILL LEACHATE POND CLOSURE AS-BUILT RECORD DRAWINGS	
DESIGNED BY: NAC	SCALE: 1"=50'	EXCAVATION GRADES	
APPROVED BY: DRF	DATE: 4-2005		
PATH: C:\FEI\SITES\BT\BT001		PROJECT NO.: BT-001	DRAWING NO.: 003

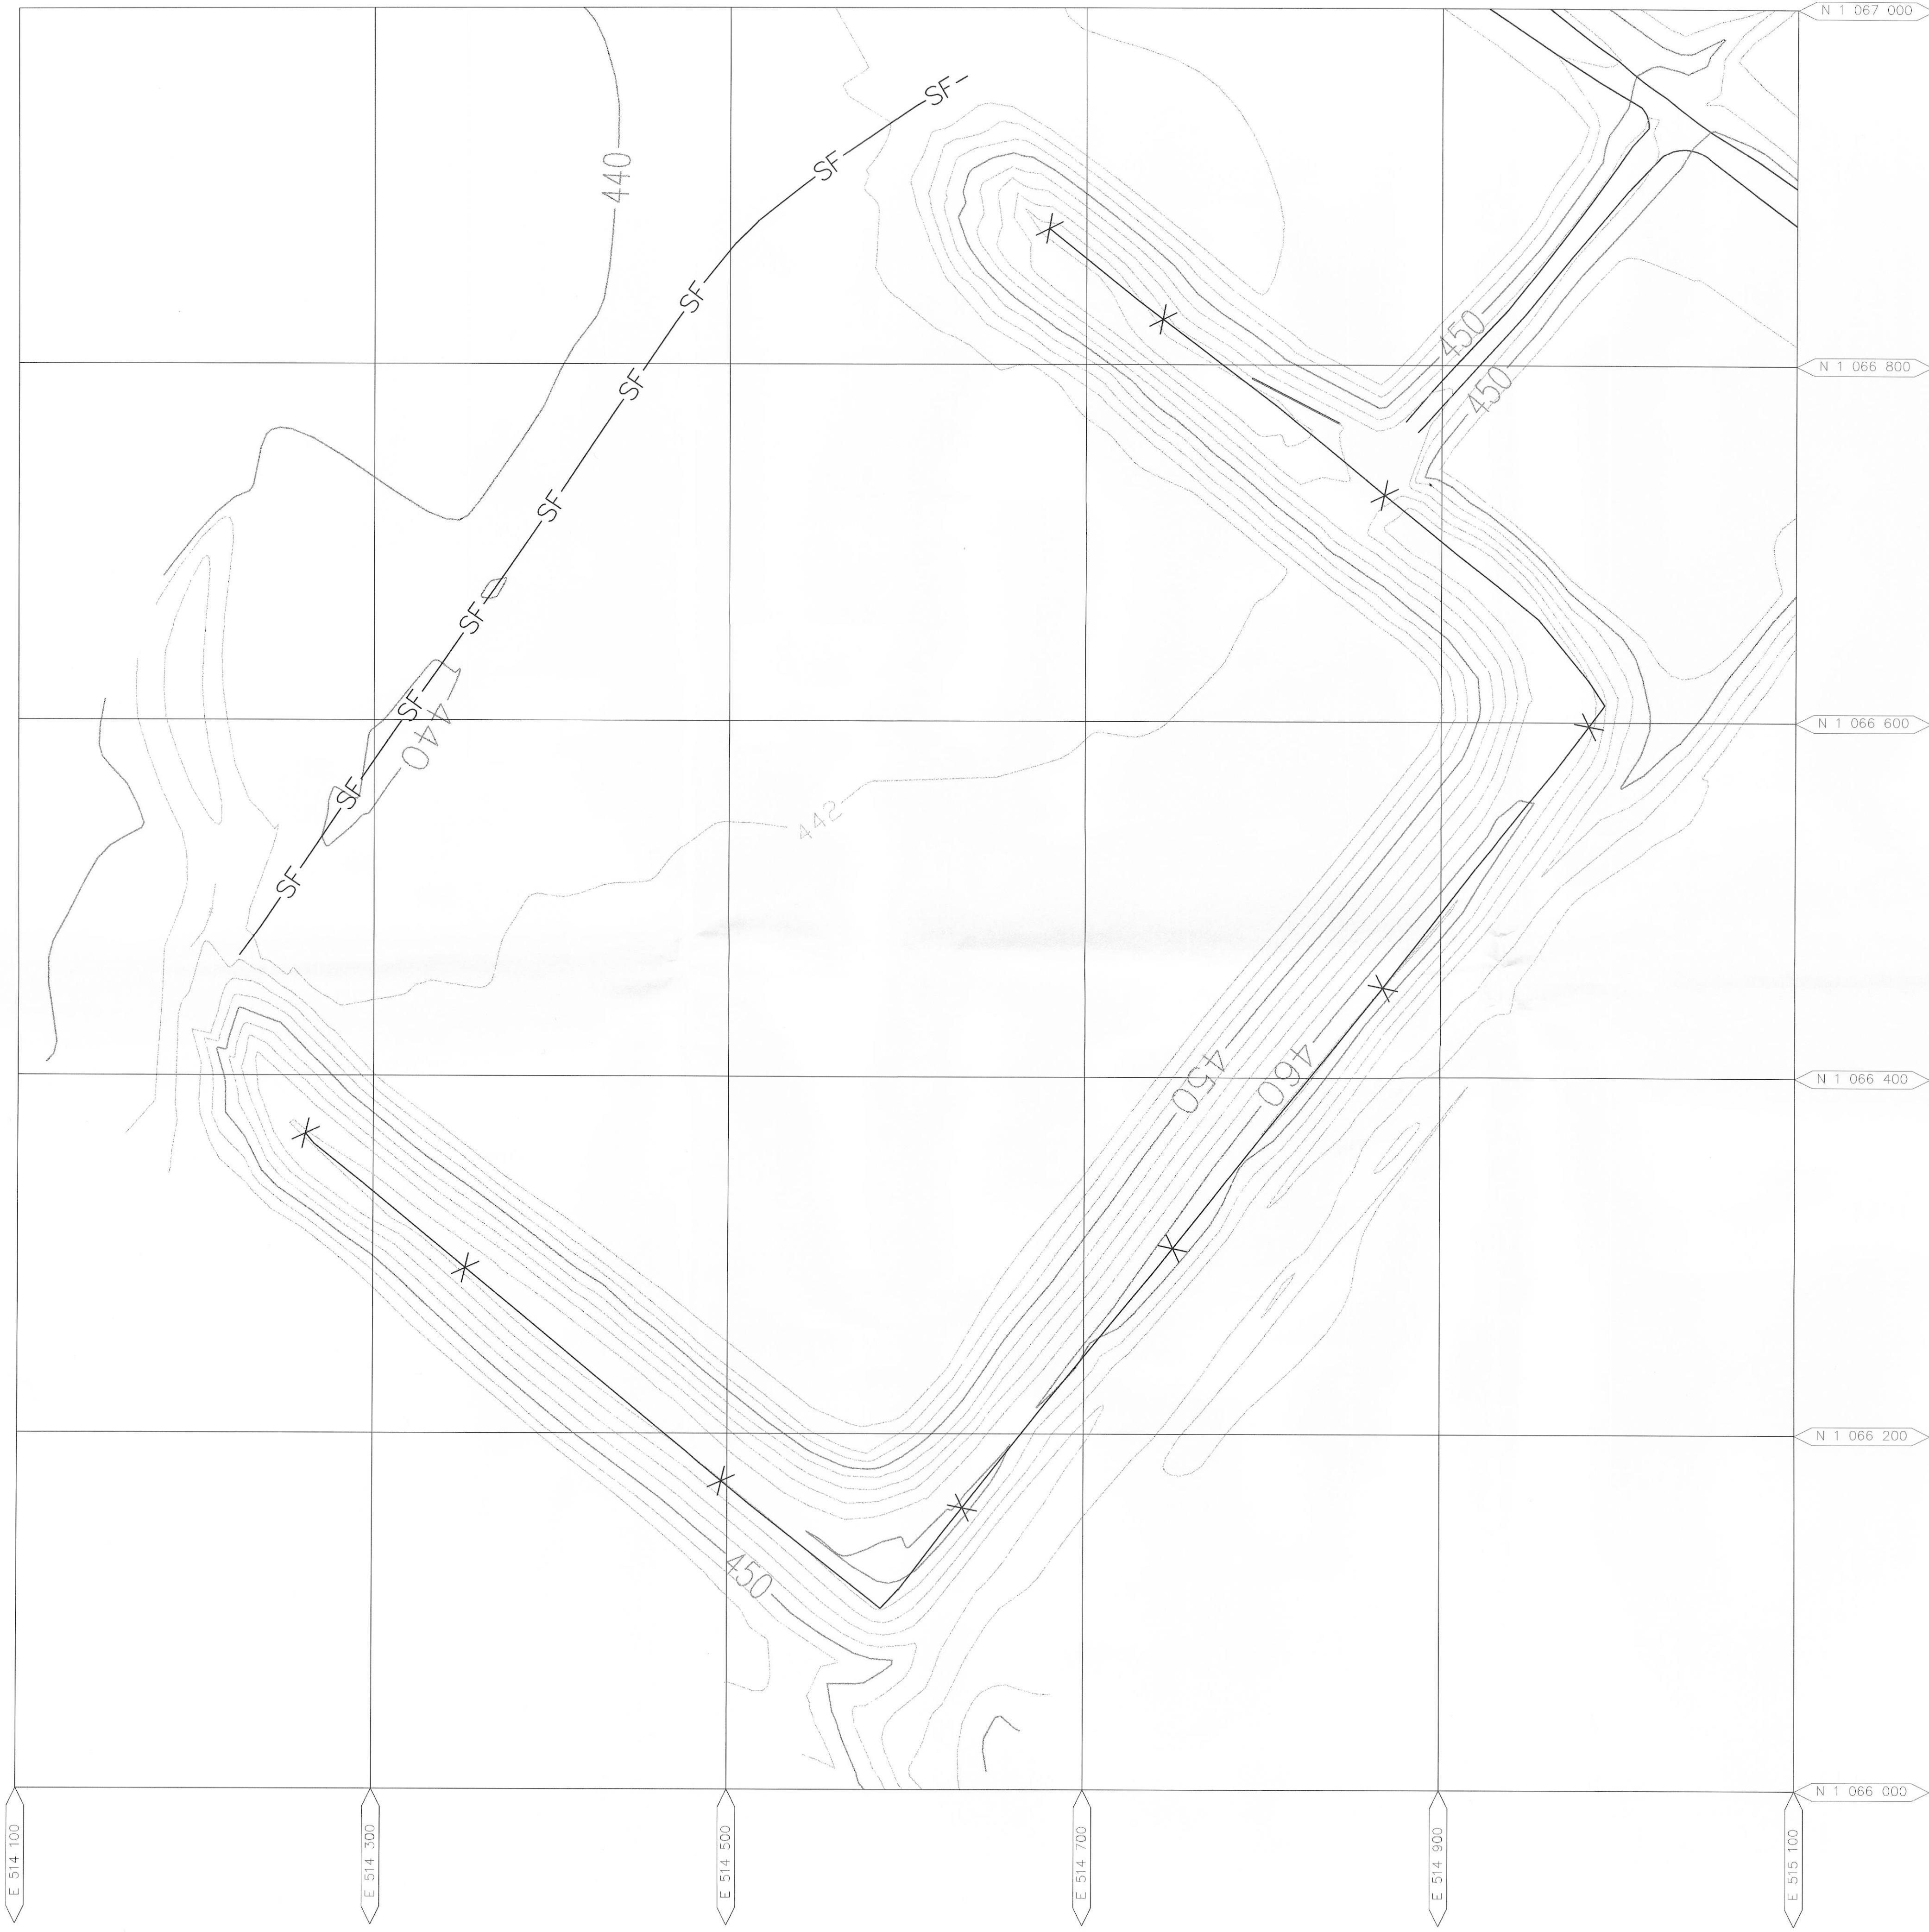

- LEGEND
- 320— INDEX CONTOUR
 - INTERMEDIATE CONTOUR
 - X— FENCELINE
 - SF— SILT FENCE

NOTE:
EXCAVATION SURVEY DATA TAKEN FROM STANLEY
HOLZHAUER, PLS SURVEY DATED 5-11-2004.

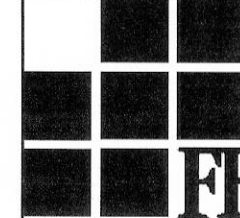 FEEZOR ENGINEERING, INC. <small>Engineering for a Better World</small>		PREPARED FOR: BRIDGETON LANDFILL L.L.C. 13570 ST. CHARLES ROCK ROAD BRIDGETON, MD 63044	
DESIGNED BY: NAC	SCALE: 1"=50'	BRIDGETON LANDFILL LEACHATE POND CLOSURE AS-BUILT RECORD DRAWINGS	
APPROVED BY: DRF	DATE: 4-2005	FINAL CONDITIONS	
PATH: C:\FEI\SITES\BT\BT001		PROJECT NO.: BT-001	DRAWING NO.: